


Client:

ltb.

Client's representative:

WeWork

Signature:

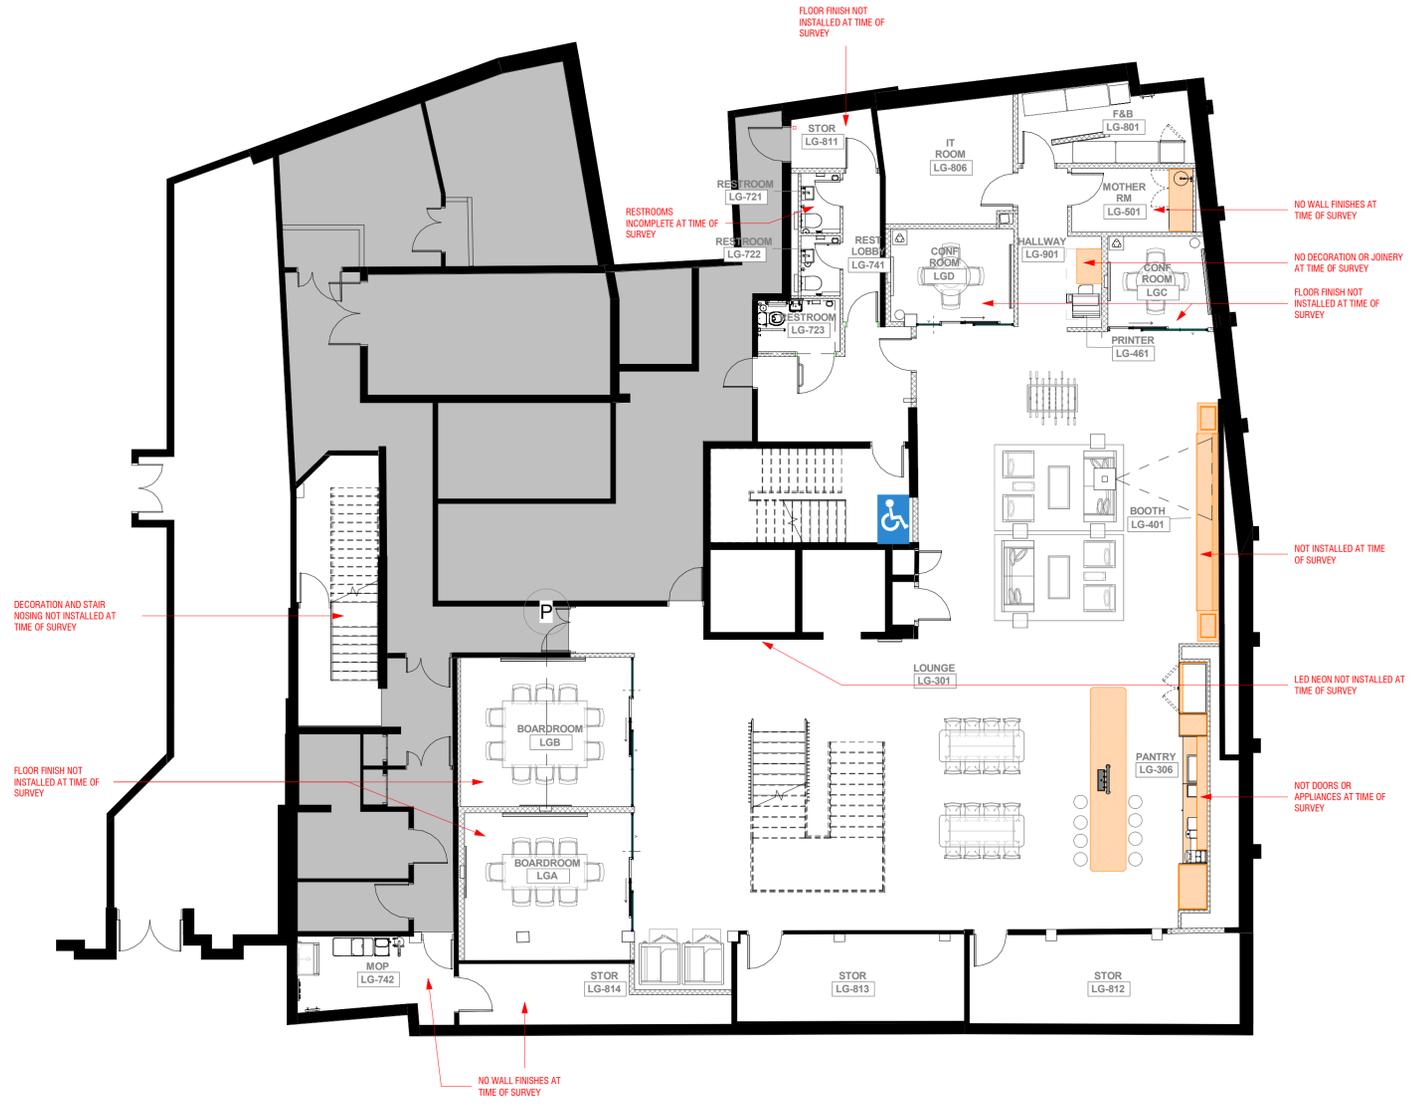

| | | | |
|-----|------------------------|----------|----------|
| A | AS BUILT | RC | 02.08.19 |
| Rev | Descriptive Amendments | Drawn By | Date |

EXISTING LEGEND

----- FIRE CURTAIN

FIRE RATED PARTITIONS AND DOORS: PLEASE REFER TO PARTITIONS DRAWINGS AND DOOR SCHEDULE

HEAD COUNT

TOILETS COUNT

| | TOILETS | DDA TOILET |
|-------|---------|------------|
| LGF | 2 | 1 |
| GF | 4 | 1 |
| 1F | 4 | 1 |
| 2F | 4 | 1 |
| 3F | 4 | 1 |
| 4F | 4 | 1 |
| 5F | 4 | 1 |
| 6F | 4 | 1 |
| TOTAL | 31 | 7 |

ALL ADAPTED WC ARE EQUIPPED WITH APPLICABLE GRAB RAILS AND OTHER ITEMS NEEDED.

JOINERY

HATCH INDICATES JOINERY. PLEASE REFER TO [A700] SHEET FOR MORE INFORMATION

PARTITIONS

EXISTING PARTITIONS

PROPOSED PARTITIONS

SHEET NOTES

REFER TO ENGINEERS FIRE STRATEGY REPORT FOR FURTHER DETAILS

*This schedule shows No. office desks counting the "ghosted" ones.

Avda. de America 52
CP 28028 Madrid
Spain

E: info@labit.es
W: www.labit.es
T: +34 915 103

Architect: Elvira Conejero Crespo

Project: **12 Moorgate, London**

Signature: _____

Job No: LB-PR-WMG-18

Scale: 1 : 100@A1

Title: **BASEMENT - AS BUILT - GENERAL ARRANGEMENT**

Sheet: **AB-A130B** Rev **A**