


Client:

lbt

Client's representative:

WeWork

Signature:

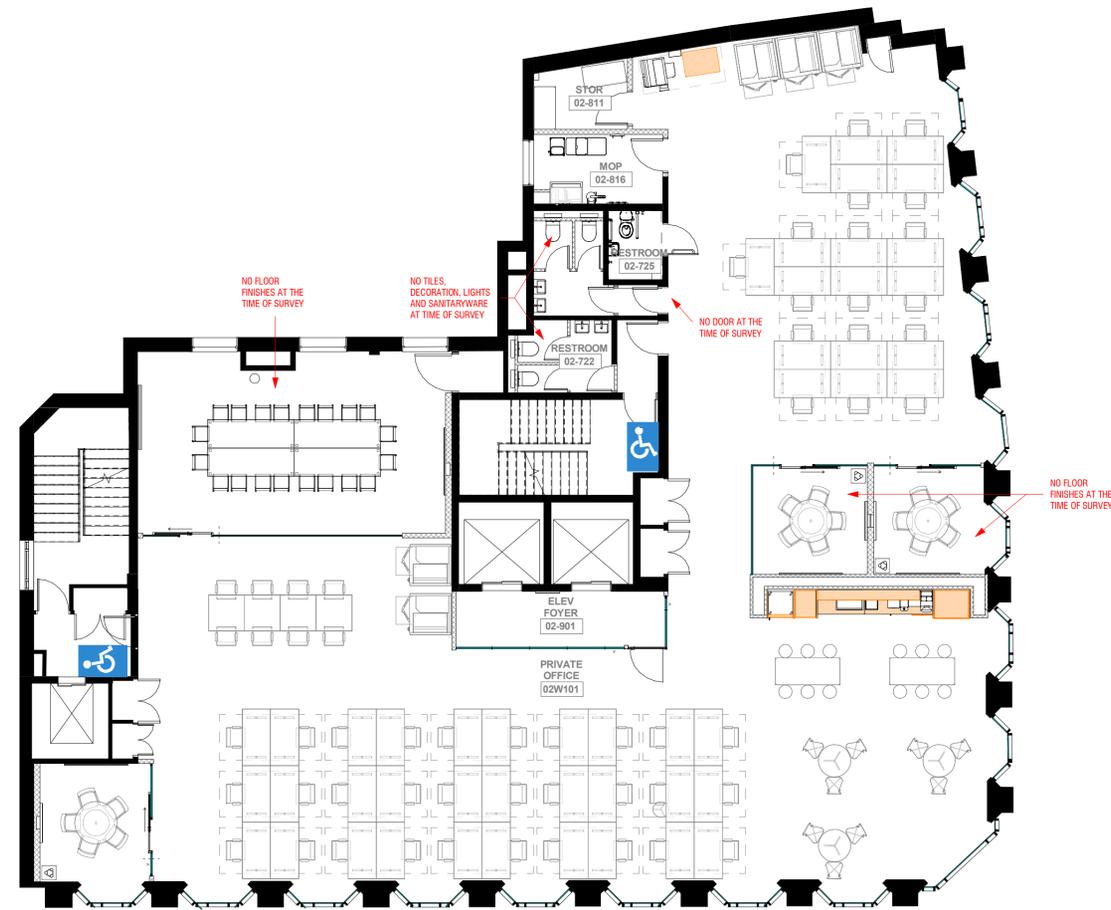

A	AS BUILT	RC	02.08.19
Rev	Descriptive Amendments	Drawn By	Date

EXISTING LEGEND

----- FIRE CURTAIN

FIRE RATED PARTITIONS AND DOORS. PLEASE REFER TO PARTITIONS DRAWINGS AND DOOR SCHEDULE

HEAD COUNT

DESKS COUNT SCHEDULE			
Description	Type	Comments	OCCUPANCY
AOR - 0RD FLOOR			
WW DESK			16
WW DESK			44
WW DESK		GHOSTED	23
			83
AOR - 1ST FLOOR			
WW DESK			65
WW DESK			5
WW DESK		GHOSTED	33
			103
AOR - 2ND FLOOR			
WW DESK			48
			48
AOR - 3RD FLOOR			
WW DESK			60
WW DESK		GHOSTED	4
			64
AOR - 4TH FLOOR			
WW DESK			74
WW DESK		GHOSTED	39
			113
AOR - 5TH FLOOR			
WW DESK			70
WW DESK		GHOSTED	31
			101
AOR - 6TH FLOOR			
WW DESK			58
WW DESK		GHOSTED	31
			89
TOTAL WEWORK DESKS			601

*This schedule shows No. office desks counting the "ghosted" ones.

TOILETS COUNT

	TOILETS	DDA TOILET
LGF	2	1
GF	4	1
1F	4	1
2F	4	1
3F	4	1
4F	4	1
5F	4	1
6F	4	1
TOTAL	31	7

ALL ADAPTED WC ARE EQUIPPED WITH APPLICABLE GRAB RAILS AND OTHER ITEMS NEEDED.

JOINERY

HATCH INDICATES JOINERY. PLEASE REFER TO (A700) SHEET FOR MORE INFORMATION

PARTITIONS

EXISTING PARTITIONS

PROPOSED PARTITIONS

SHEET NOTES

REFER TO ENGINEERS FIRE STRATEGY REPORT FOR FURTHER DETAILS

labit group

Avda. de America 52
CP 28028 Madrid
Spain

E: info@labit.es
W: www.labit.es
T: +34 915 103

Architect: Elvira Conejero Crespo

Project: **12 Moorgate, London**

Signature:

Job No: LB-PR-WMG-18

Scale: 1 : 100@A1

Title: 2ND FLOOR - AS BUILT - GENERAL ARRANGEMENT

Sheet: **AB-A132** Rev: **A**